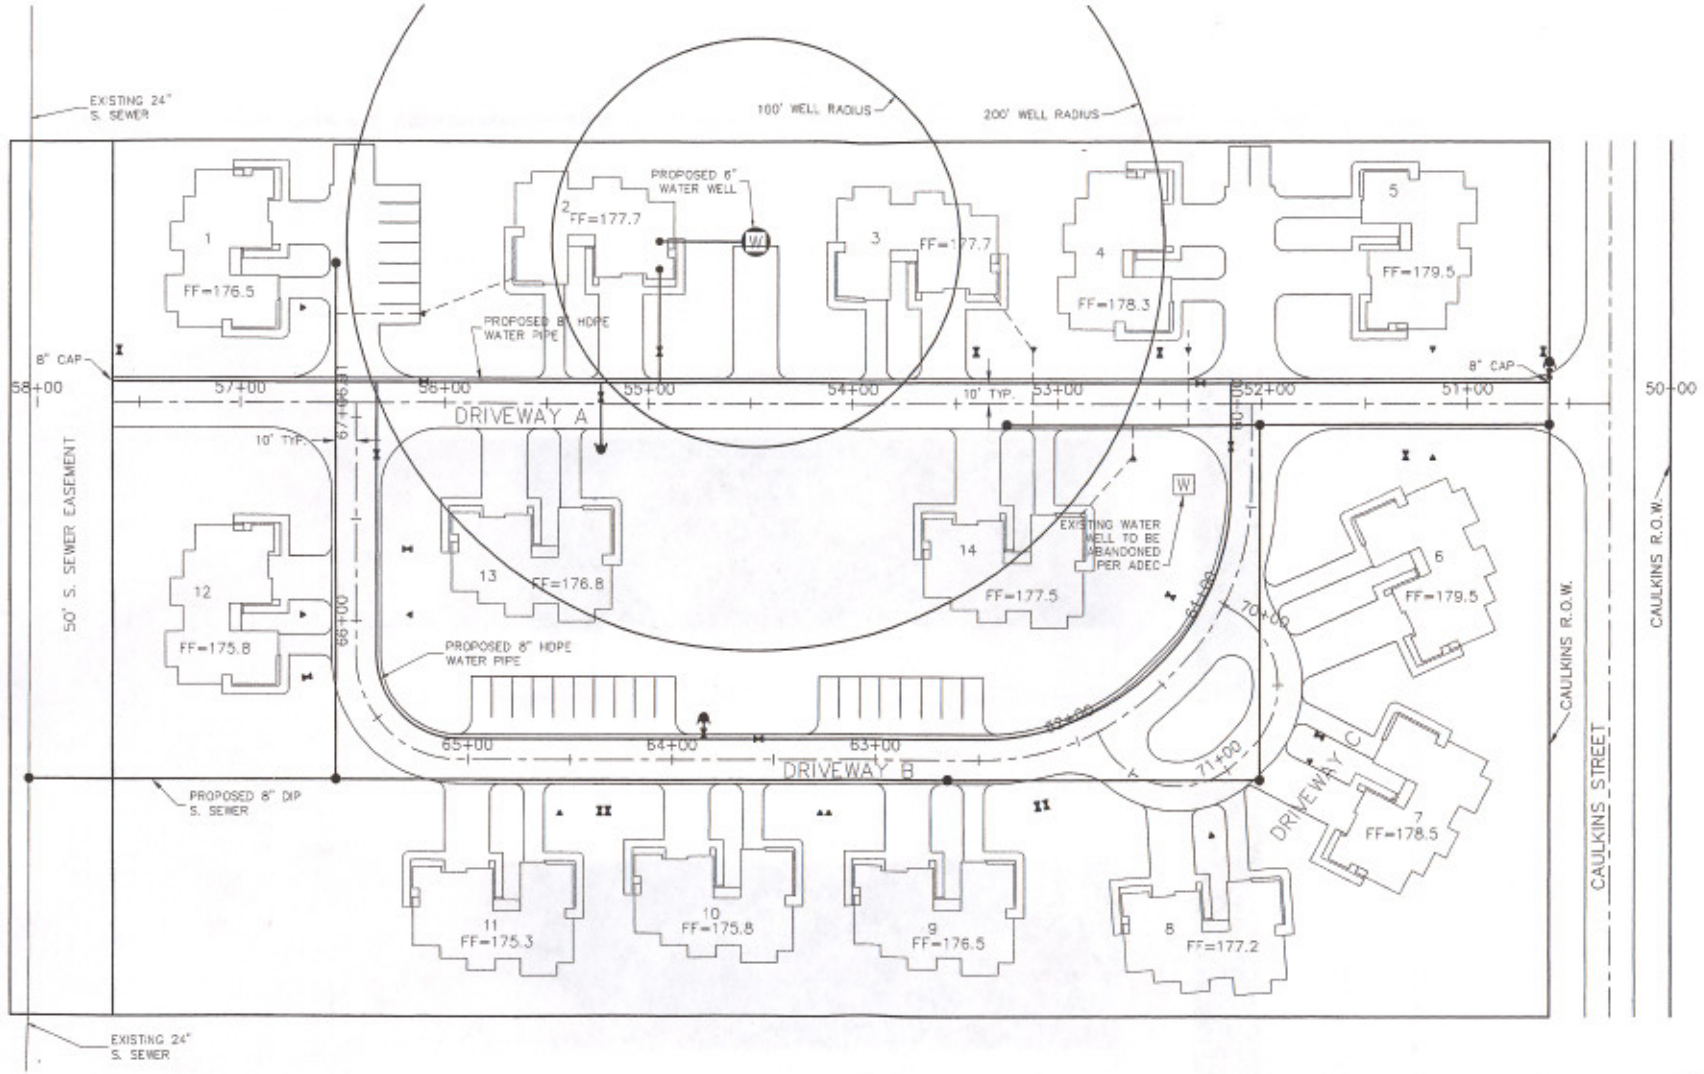

PROTECTIVE WATER WELL RADIUS PLAN

SCALE: 1" = 30'

PEAK TOWN HOMES
PALMER, ALASKA
PROTECTIVE WATER WELL
RADIUS PLAN

RECORD DRAWING

REVISIONS

SHEET A OF A